


**1 BUILDINGS 1 THRU 20 - First Floor Plan**  
 A3.1 1/8" = 1'-0"

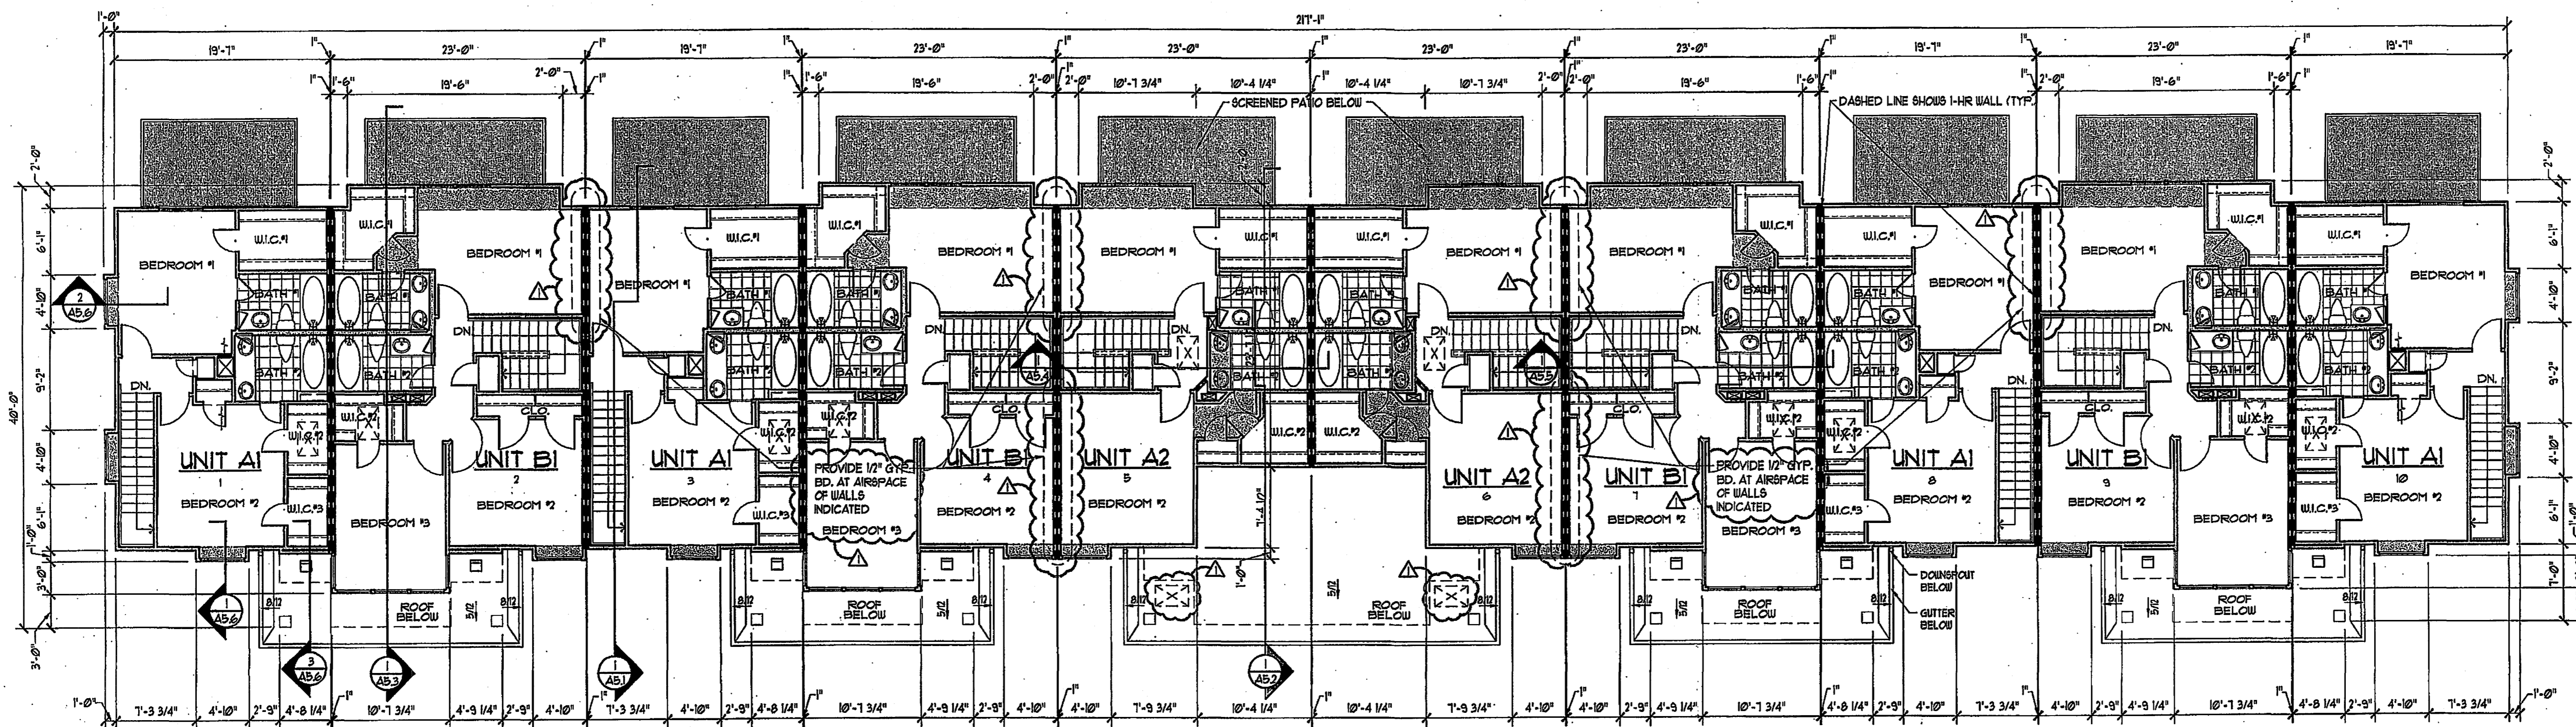

**2 BUILDINGS 1 THRU 20 - Second Floor Plan**  
 A3.1 1/8" = 1'-0"

AS BUILT ISSUE  
 08-07-03

Copyright © 2001 The Barrington Group Incorporated

Ted Trout  
 Architect  
 Florida Registration #A0016024  
 P.O. Box 820612  
 Houston, Texas 77282  
 Tel: (713) 818-5351  
 Fax: (281) 531-4333

Design Consultant  
 Matusky & Associates  
 100 West Gray Street  
 Houston, Texas 77019  
 Tel: (713) 512-1111  
 Fax: (713) 512-1111

CAROLINA LANDINGS  
 At University Place  
 Harris County, Florida  
 Job No. 0316

CLIENT REVIEW	Date: 11-27-01
INITIAL PERMIT REVIEW	Date: 12-05-01
PERMIT ISSUING	Date: 12-10-01
PERMIT/PRICING REV.	Date: 01-28-02
AS BUILT ISSUE	Date: 08-07-03
Date:	
Date:	
Date:	

A3.1

P:\2001 Jobs\0138 Carolina Landings\0138\_A301.dwg 8/7/2003 8:25:29 PM, MW