


**STUDS**  
(SOUTHERN YELLOW PINE STUD GRADE)

LEVEL	SA	SB	S1	S2
2	2 X 4 @ 12" O.C.	2 X 4 @ 16" O.C.	2 X 4 @ 16" O.C.	
1	2-2 X 4 @ 16" O.C.	2 X 4 @ 16" O.C.		2 X 6 @ 16" O.C.


- STUD SCHEDULE NOTES:  
 1. ALL SHEARWALLS SHALL HAVE STUDS @ 16" O.C.  
 2. RE: ARCH. PLANS FOR ALL NON-LOAD BEARING INTERIOR PARTITIONS.  
 3. IF TRUSSES BEAR ON WALL ALIGN MULTIPLE STUDS WITH TRUSS ABOVE.  
 4. ALL 6" WALLS USE 1-2 X 6 @ 16" O.C.

SYMMETRICAL ABOUT C (U.N.O.)

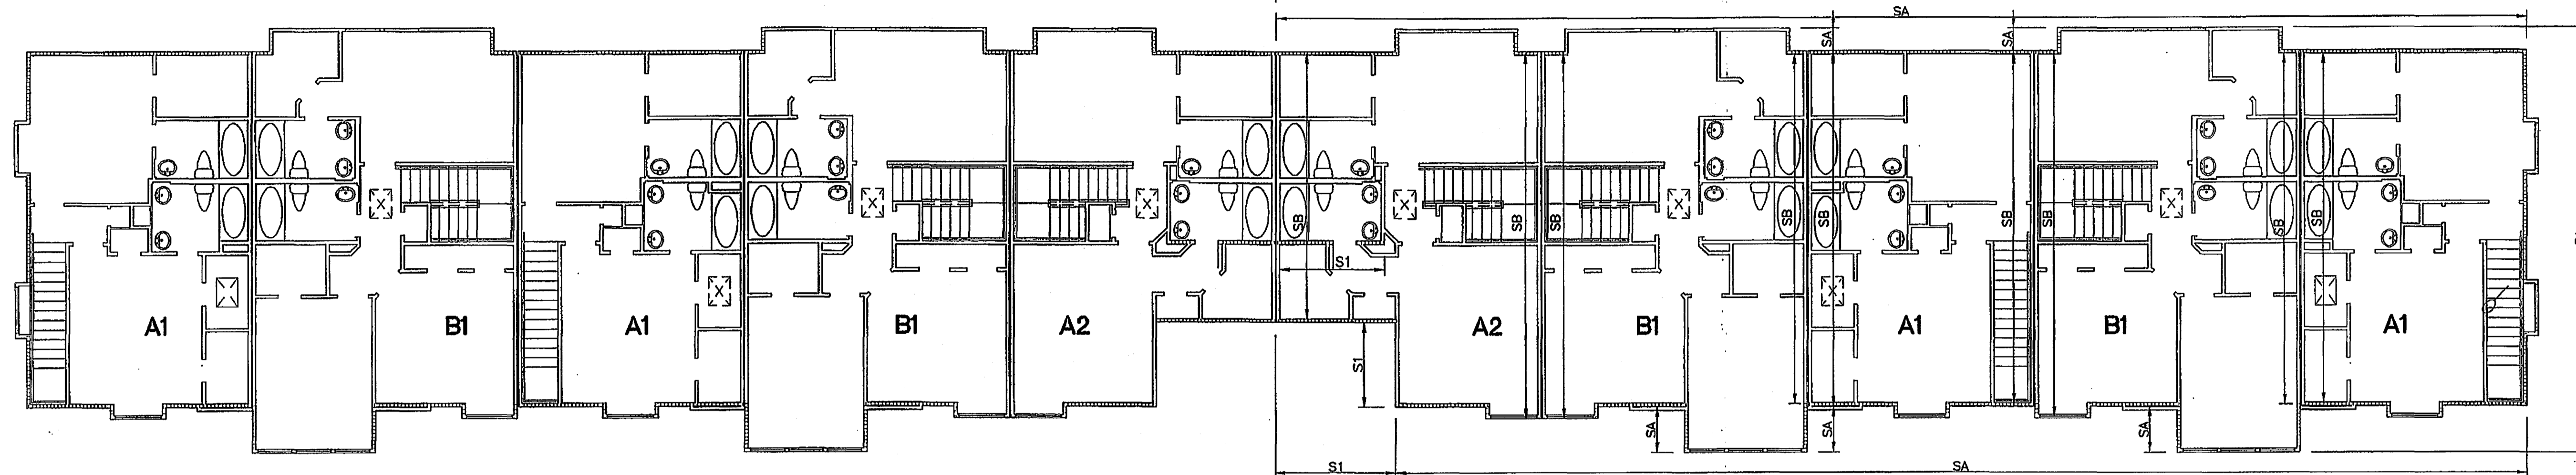

**STUD LAYOUT PLAN (2nd FLOOR)**  
 BUILDING NO's: 1 - 20  
 SCALE: 1/8" = 1'-0"

SYMMETRICAL ABOUT C (U.N.O.)

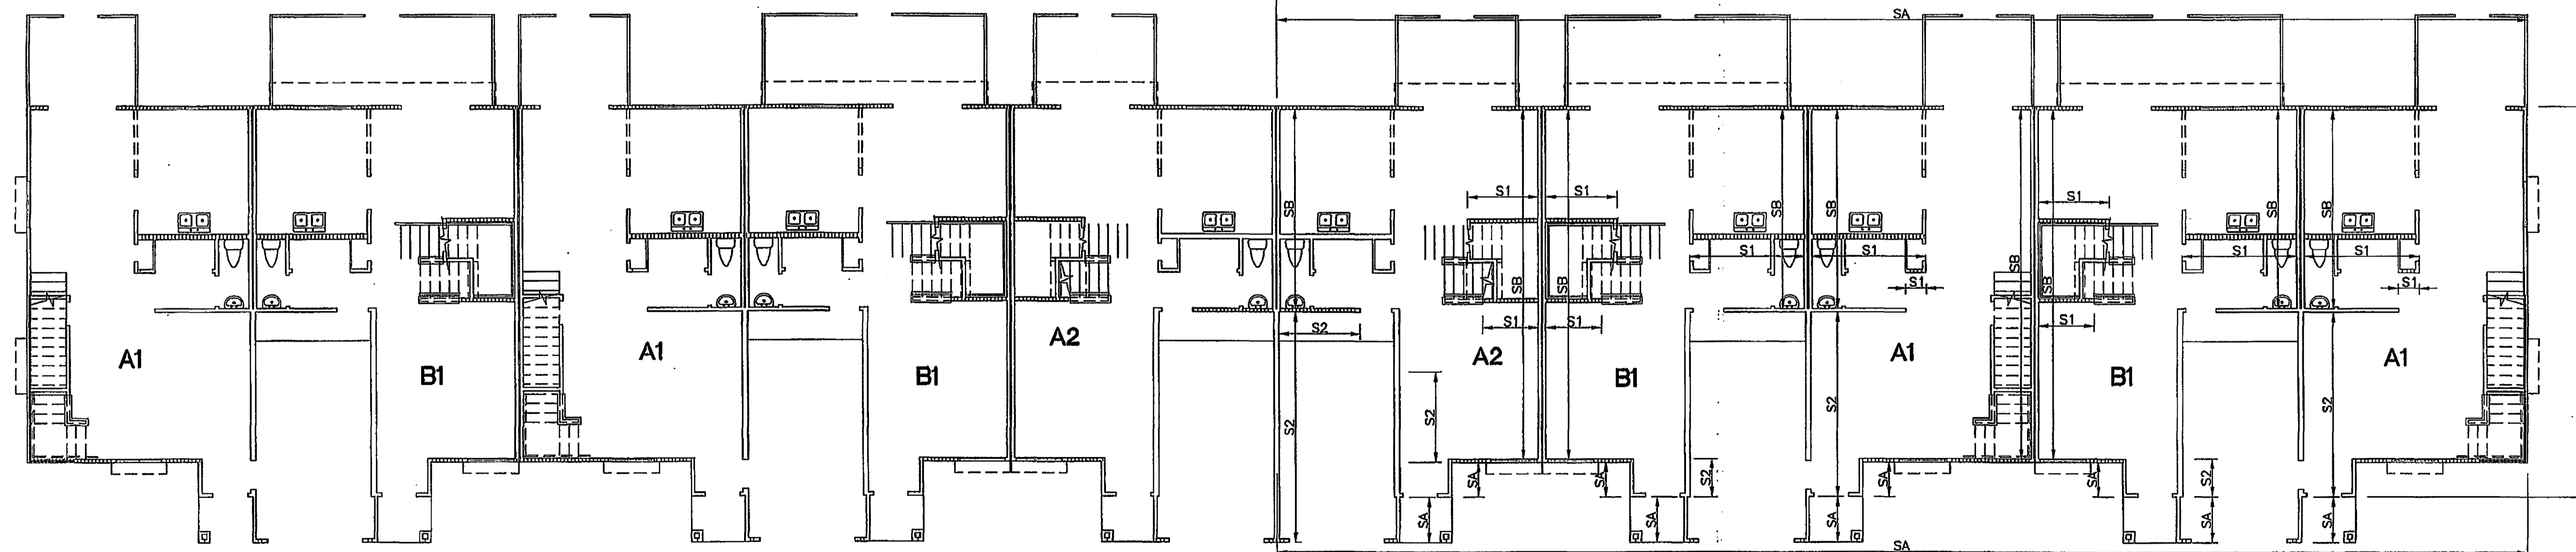

**STUD LAYOUT PLAN (1st FLOOR)**  
 BUILDING NO's: 1 - 20  
 SCALE: 1/8" = 1'-0"

Project  
**CAROLINA LANDINGS APARTMENTS**  
 MANATEE COUNTY, FLORIDA  
 TOWNHOME RENTAL COMMUNITY



**CONSULTING ENGINEERS**

CORPORATE OFFICE  
 10101 Southwest Freeway, Suite 600  
 Houston, Texas 77074-1126  
 713.779.7252 1.800.422.7252  
 FAX: 713.779.1173  
 e-mail: sca@scahouston.com

Louisville, Kentucky 502.426.8789  
 Orlando, Florida 407.893.6200

ISSUE DATES

Review Issue  
 xxxxx  
 Bid Issue  
 12-10-2001  
 Permit Issue  
 12-10-2001  
 Construction Issue  
 03-12-2002

Revisions

02-07-2002 REISSUE FOR PERMIT-AMENITY

Drawn ES	Project 21510
Drawn BA	Sheet
Check MLS	<b>S3.01</b>
Date 03-12-2002	

AS BUILT ISSUE  
 08-07-03