


1 UNIT 'A2' - Two Bedroom, 2 1/2 Bath  
 P22 1/4" = 1'-0"

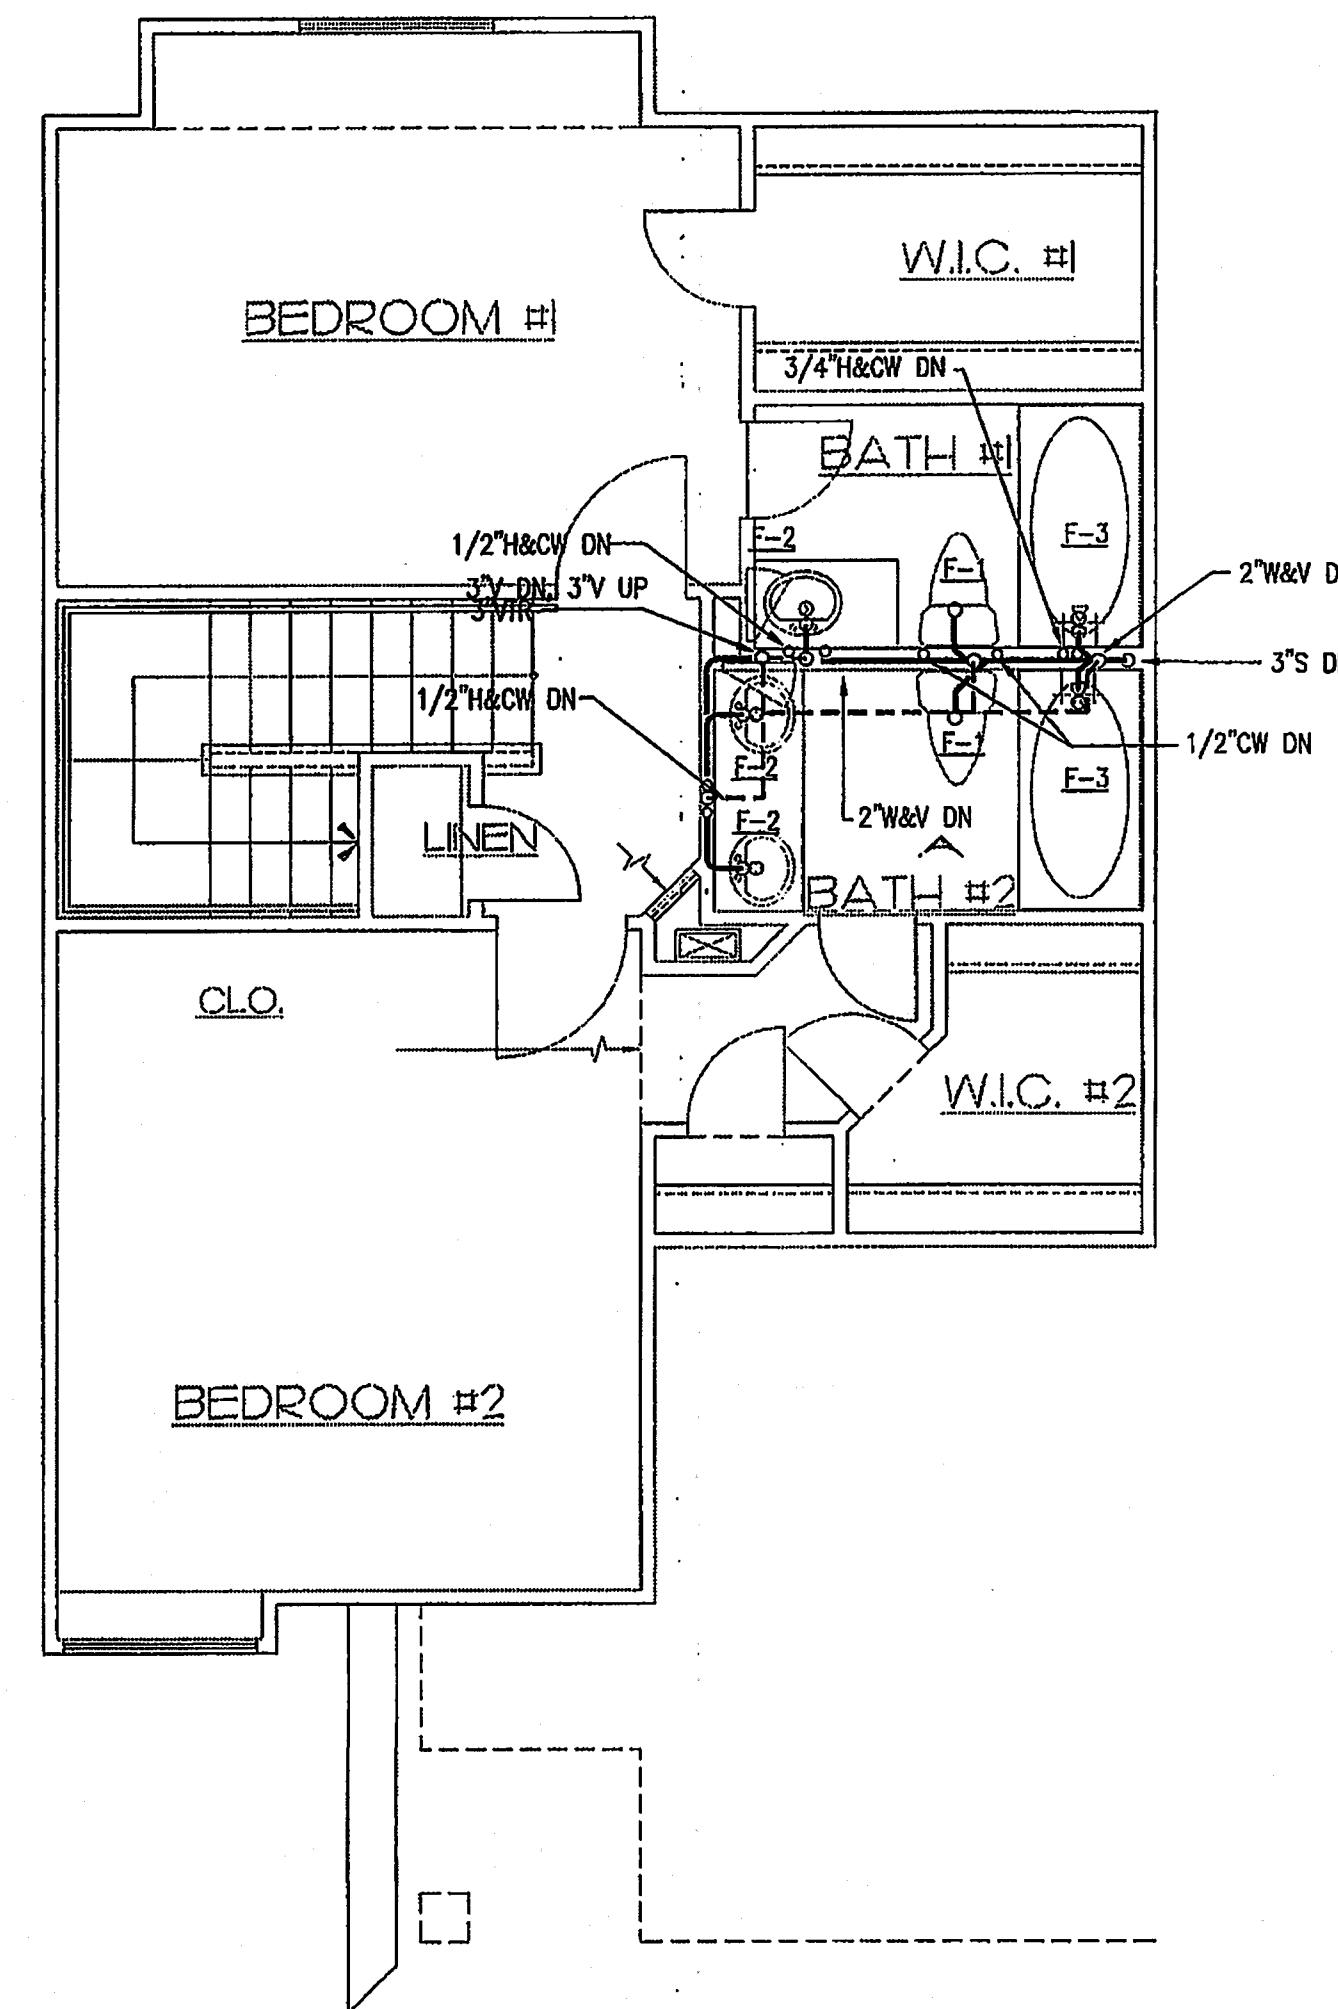


2 UNIT 'A2' - Two Bedroom, 2 1/2 Bath  
 P22 1/4" = 1'-0"

AS BUILT ISSUE  
 08-07-03

**Jordan & Skala Engineers, Inc.**  
 Job Number - 0110380  
 6030-P UNITY DRIVE, NORCROSS, GA 30071  
 PHONE (770)447-5547 FAX (770)445-0262  
 EMAIL: jordan@jordan-engineers.com

COPYRIGHT © 2001 JORDAN & SKALA ENGINEERS INC.

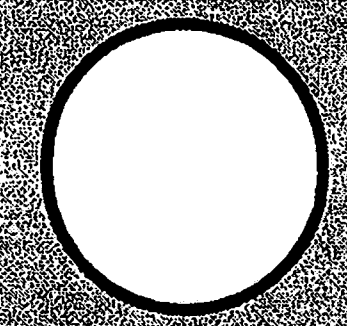

**Carolina Landing at University Place**  
 A Townhome Rental Community  
 Alachua County, Florida  
 Job No. 01-03

Date:	12-10-01
Date:	
Date:	
