


1 **UNIT 'B1' - Three Bedroom, 2 1/2 Bath**
 P2.3 1/4" = 1'-0"

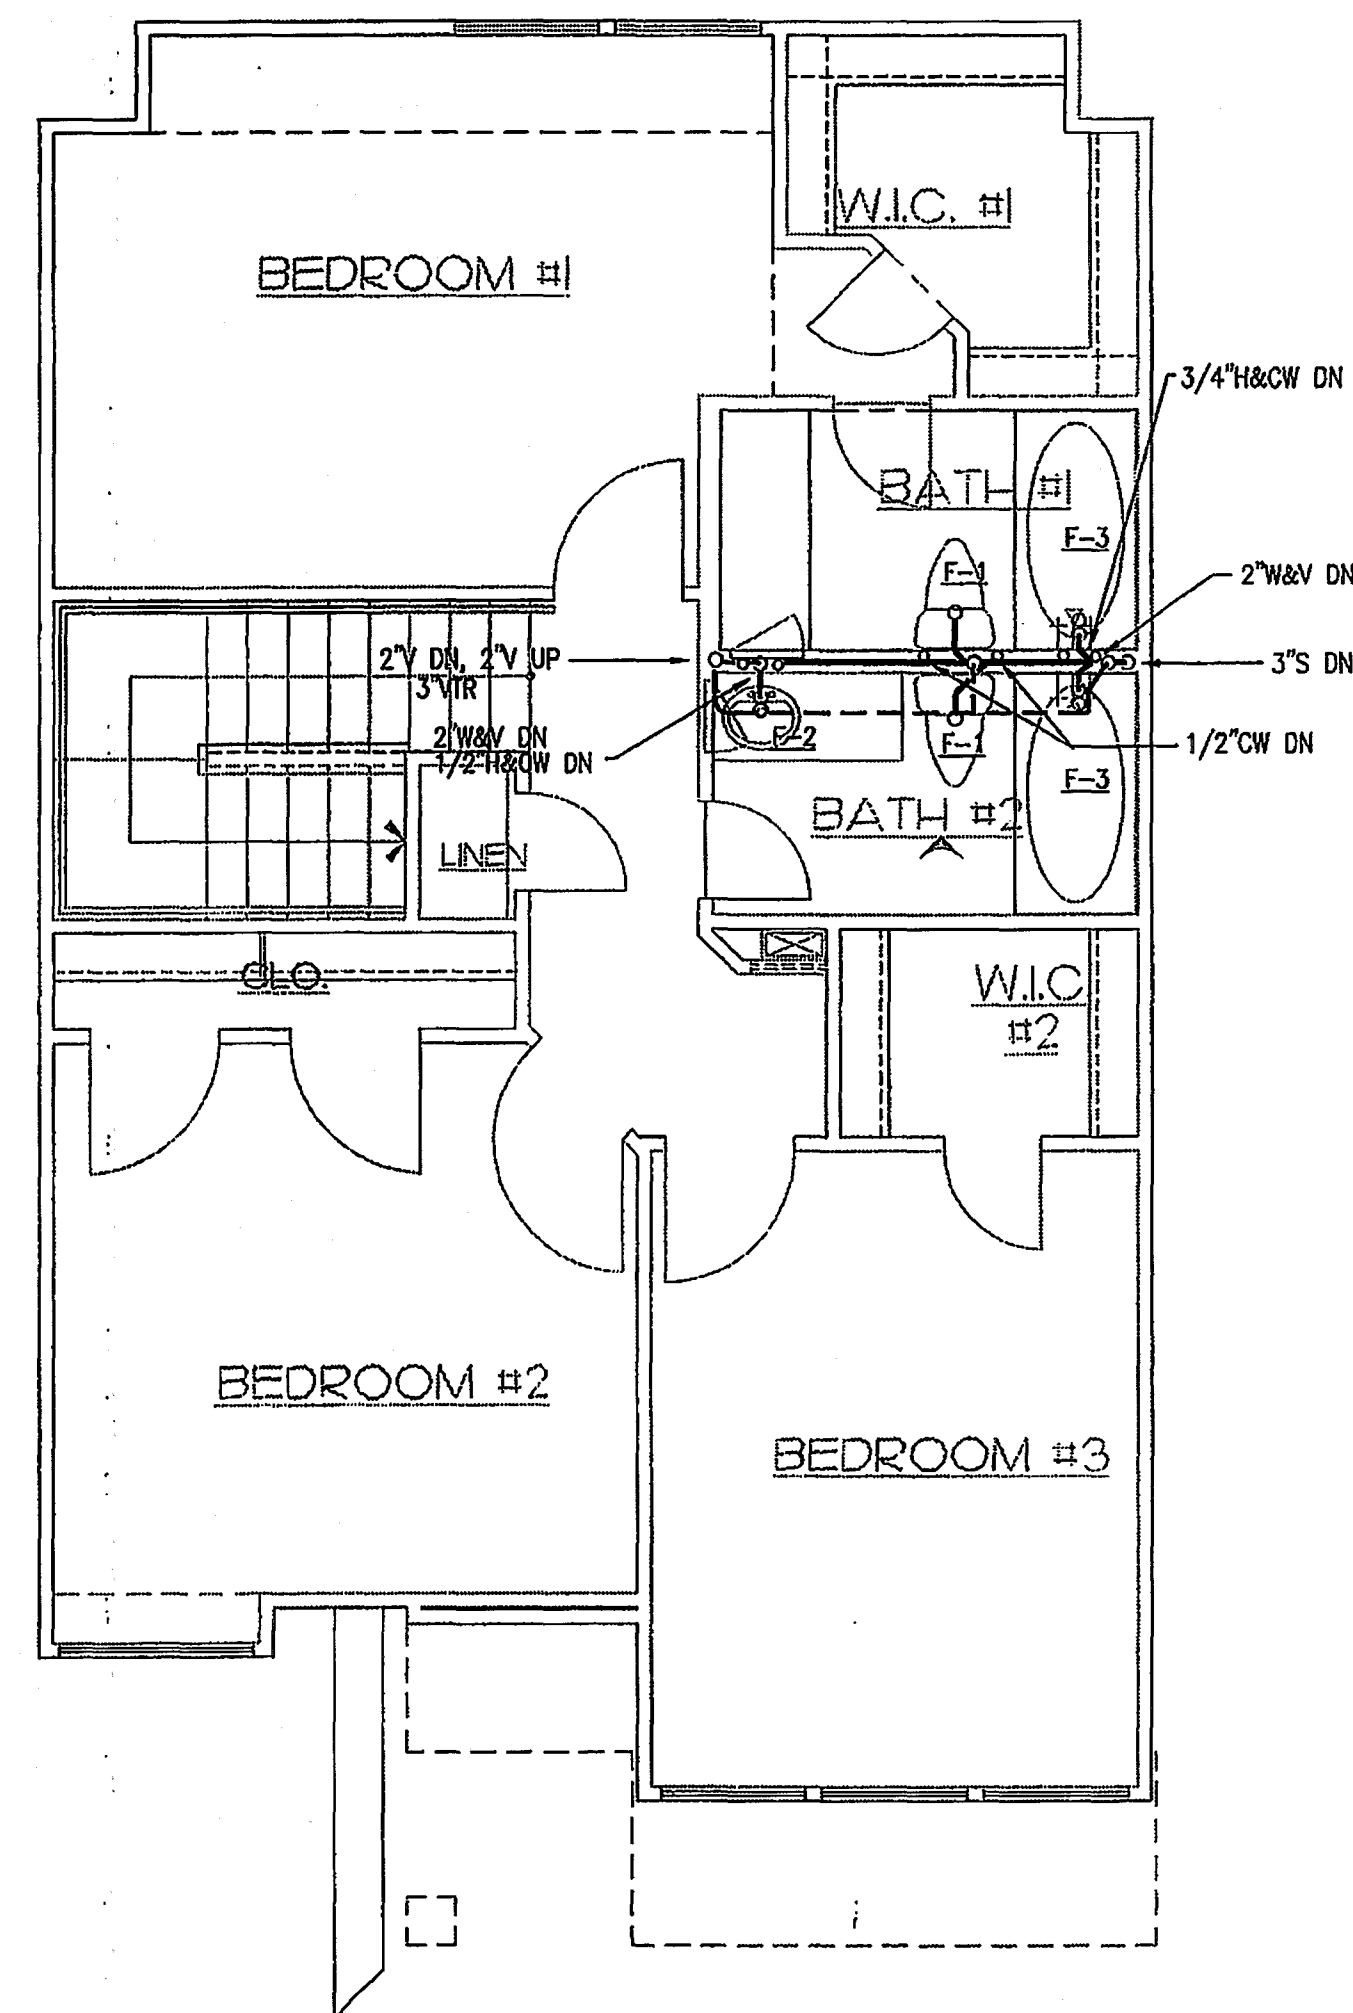

2 **UNIT 'B1' - Three Bedroom, 2 1/2 Bath**
 P2.3 1/4" = 1'-0"

AS BUILT ISSUE
 08-07-03

Jordan & Skala Engineers, Inc.
 Job Number - 0110380
 6030-P UNITY DRIVE, NORCROSS, GA 30071
 PHONE (770)447-5547 FAX (770)448-0282
 EMAIL: js@jordanskala.com
 COPYRIGHT © 2001 JORDAN & SKALA ENGINEERS, INC.

Carolina Landing at University Place
 A Townhome Rental Community
 Manatee County, Florida
 3565 N. 114TH

Date:	12-10-01
Date:	
Date:	
P2.3