


1 BUILDINGS 1 THRU 20 - First Floor Plan
 P3.1 1/8" = 1'-0"

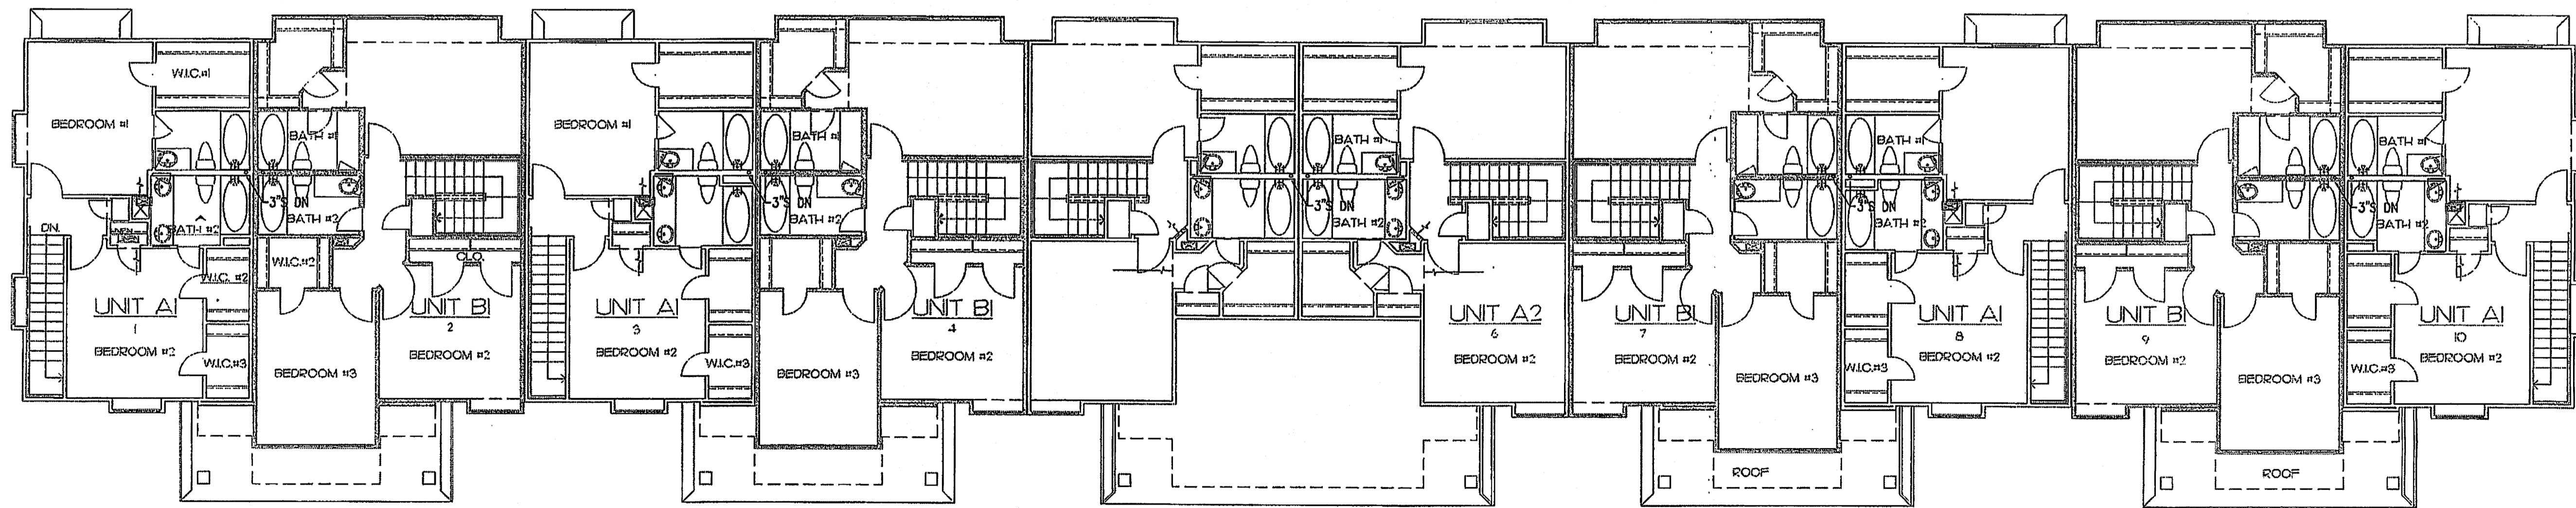

2 BUILDINGS 1 THRU 20 - Second Floor Plan
 P3.1 1/8" = 1'-0"

AS BUILT ISSUE
08-07-03

Jordan & Skala Engineers, Inc.
 Job Number - 0110380
 6030-P UNITY DRIVE, NORCROSS, GA 30071
 PHONE (770)447-5547 FAX (770)448-0262
 EMAIL: jse@jordanskala.com

COPYRIGHT © 2001 JORDAN & SKALA ENGINEERS INC.

Carolina Landing at University Place
 A Townhome Rental Community
 160 N. D. 10
 92

Date: 12-10-01
Date:
Date:
P3.1