ACCESSIBILITY STANDARDS
(Selected Details from ANSI A117.1)

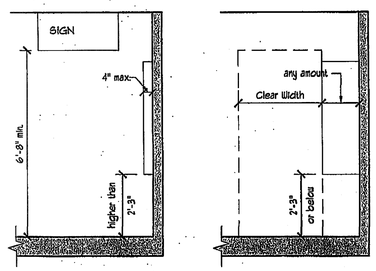

Fig. 8(a) Walking Parallel to Wall

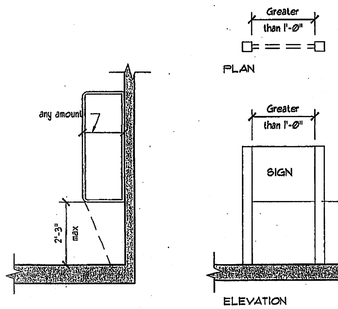

Fig. 8(b) Walking Perpendicular to Wall

Fig. 8(C) Free Standing Overhanging Objects

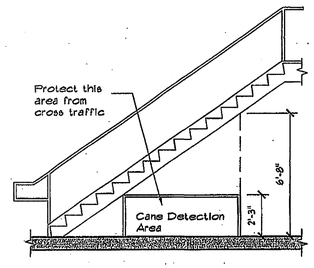

Fig. 8(c-1) Overhead Hazards

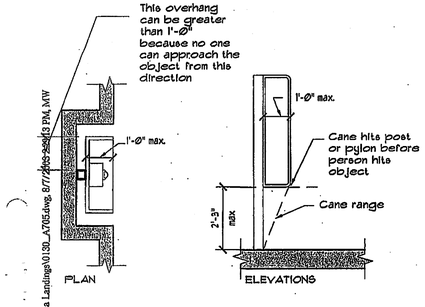

Fig. 8(d) Objects Mounted on Posts or Pylons

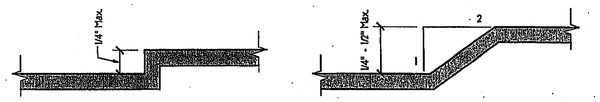

Fig. 7 Accessible Route

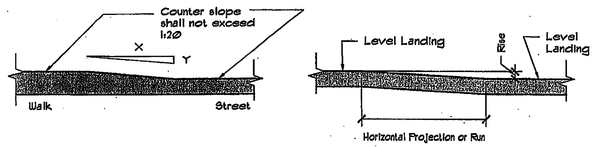

Fig. 11 Measurement of Curb Ramp Slopes

	Maximum Rise	Maximum Horizontal Projection
Slope	In.	Ft.
1:12 to 1:15	30	30
1:16 to 1:19	30	40
1:20	30	50

4.8.2 Fig. 16 Components of a Single Ramp

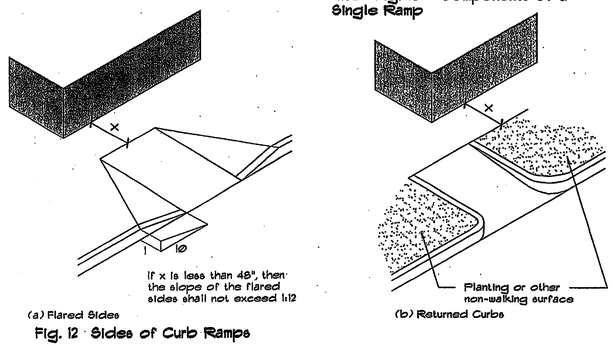

Fig. 12 Sides of Curb Ramps

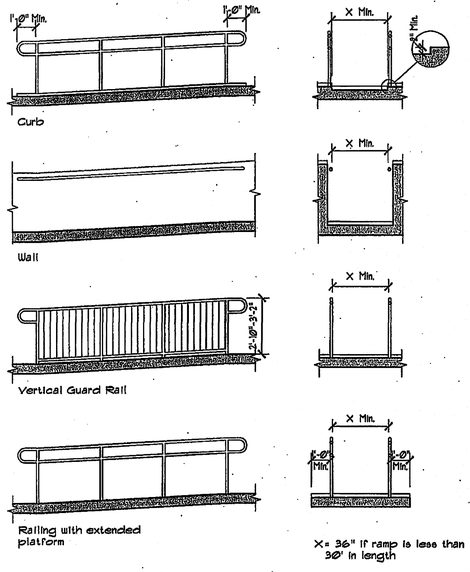

Fig. 17 Examples of Edge Protection and Handrail Extensions

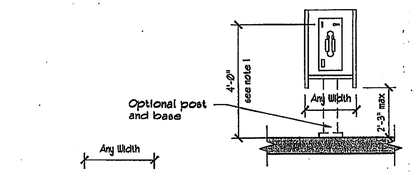

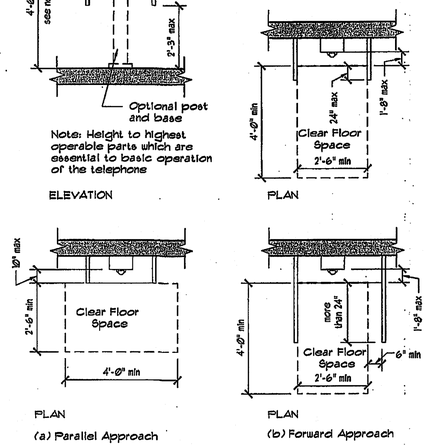

Fig. 44 Mounting Heights and Clearances for Telephones

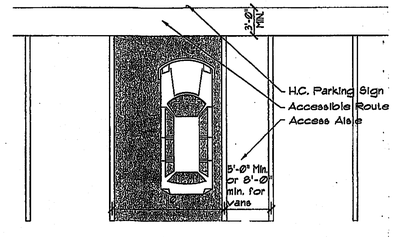

Fig. 10 Dimensions of Parking Spaces

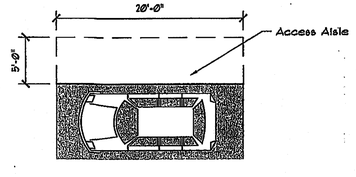

Fig. 10 Access Aisle at Passenger Loading Zones

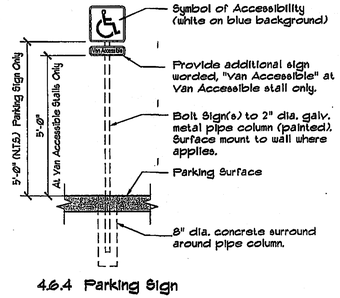

4.6.4 Parking Sign

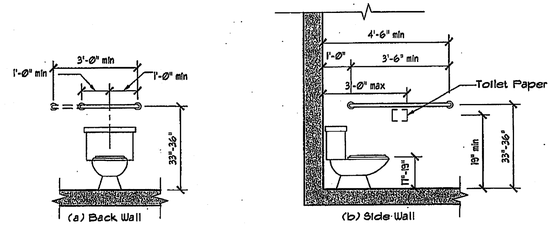

Fig. 29 Grab Bars at Water Closets

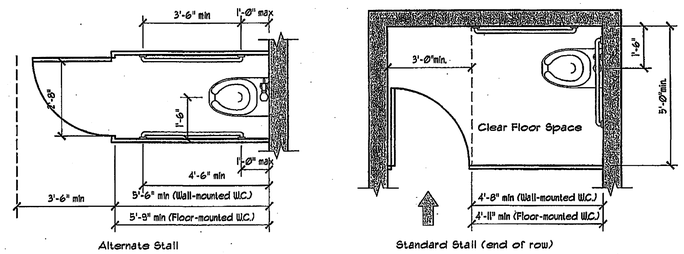

Fig. 30 Toilet Stalls

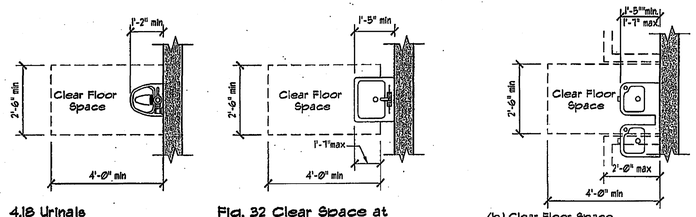

4.18 Urinals

Fig. 32 Clear Space at Lavatories

(b) Clear Floor Space

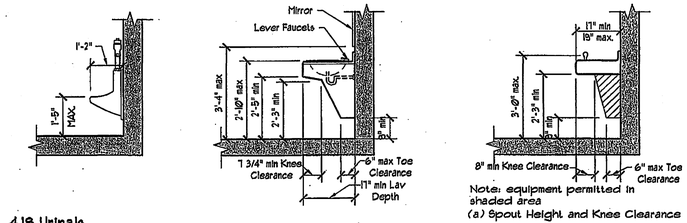

Fig. 31 Lavatory Clearances

Note: equipment permitted in shaded area

(a) Spout Height and Knee Clearance

Fig. 27 Drinking Fountains and Water Coolers

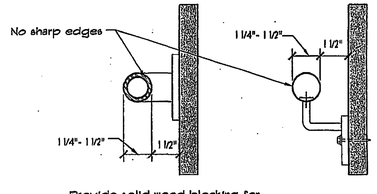

Fig. 39 (c) Grab Bar

Fig 39 (a) Handrail

AS BUILT ISSUE
08-07-03

Copyright © 2001 The Barrington Group Incorporated

Project Architect:
Ted Trout Architect
Florida Registration #AR0016924
P.O. Box 820632
Houston, Texas 77282
Tel: (713) 818-3351
Fax: (281) 531-4533

Design Consultant:
Mucasey & Associates
2144 West Gray, Suite 101
Houston, Texas 77019
Tel: (713) 521-7272
Fax (713) 521-7273

CAROLINA LANDINGS
At University Place
Manatee County, Florida
Job No. 0130

INITIAL PERMIT ISSUE	
Date: 12-05-01	
PERMIT ISSUE	
Date: 12-10-01	
AS BUILT ISSUE	
Date: 08-07-03	
Date:	
Date:	
Date:	
Date:	
Date:	

A7.5

G:\2001 Jobs\0130_Carolina Landings\0130_A705.dwg, 8/7/2003 2:33:13 PM, JMW