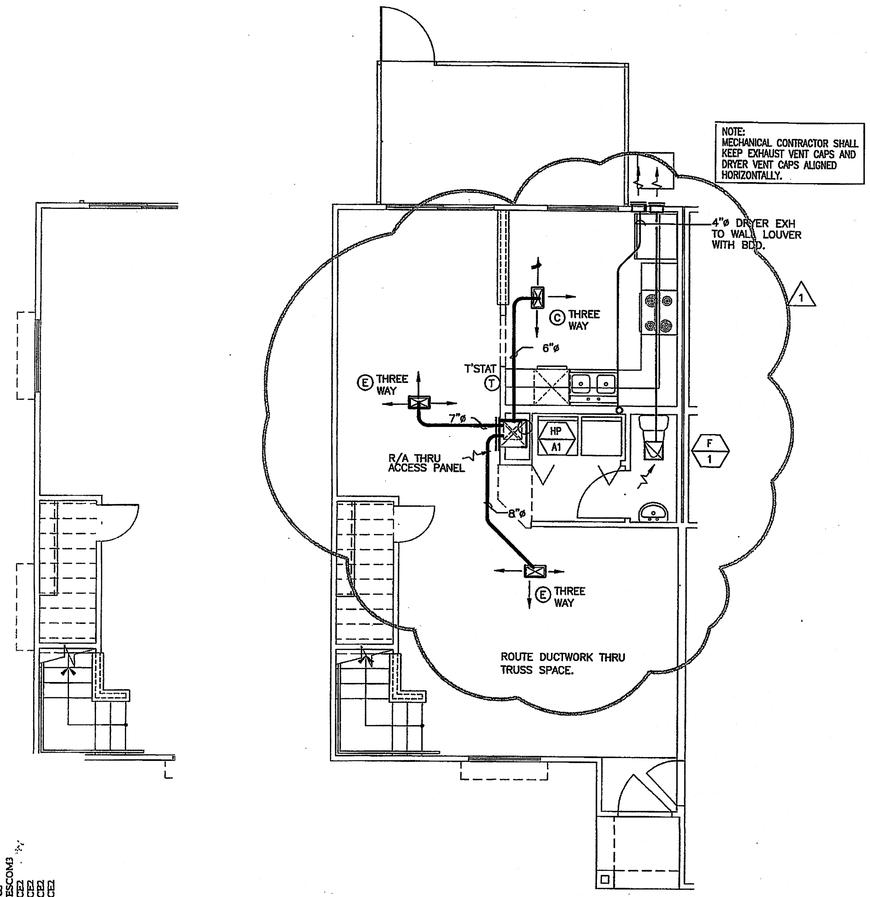

1 A21 **UNIT "A1" - Two Bedroom, 2 1/2 Bath**

1/4" = 1'-0" FIRST FLOOR PLAN - 621 .. 1,228 .. TOTAL

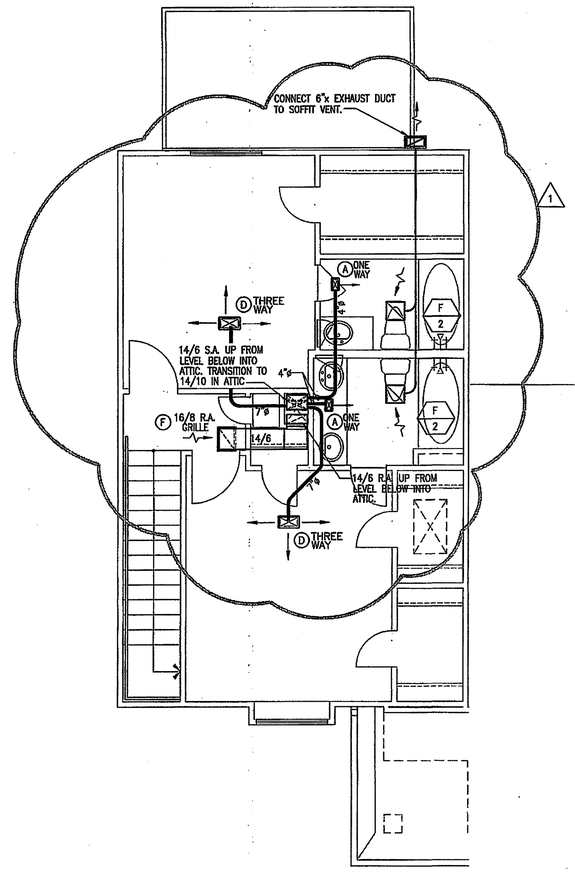

2 A21 **UNIT "A1" - Two Bedroom, 2 1/2 Bath**

1/4" = 1'-0" SECOND FLOOR PLAN - 607 .. 1,228 .. TOTAL

permit no	lot	address	permit type
01120847	BLDG 1	7700 COOPER CREEK BLVD	RESMULTI
01120863	BLDG 2	7700 COOPER CREEK BLVD	RESMULTI
01120864	BLDG 3	7700 COOPER CREEK BLVD	RESMULTI
01120865	BLDG 4	7700 COOPER CREEK BLVD	RESMULTI
01120866	BLDG 5	7700 COOPER CREEK BLVD	RESMULTI
01120867	BLDG 6	7700 COOPER CREEK BLVD	RESMULTI
01120869	BLDG 7	7700 COOPER CREEK BLVD	RESMULTI
01120873	BLDG 8	7700 COOPER CREEK BLVD	RESMULTI
01120875	BLDG 9	7700 COOPER CREEK BLVD	RESMULTI
01120880	BLDG 10	7700 COOPER CREEK BLVD	RESMULTI
01120883	BLDG 11	7700 COOPER CREEK BLVD	RESMULTI
01120889	BLDG 12	7700 COOPER CREEK BLVD	RESMULTI
01120901	BLDG 13	7700 COOPER CREEK BLVD	RESMULTI
01120902	BLDG 14	7700 COOPER CREEK BLVD	RESMULTI
01120904	BLDG 15	7700 COOPER CREEK BLVD	RESMULTI
01120917	BLDG 16	7700 COOPER CREEK BLVD	RESMULTI
01120918	BLDG 17	7700 COOPER CREEK BLVD	RESMULTI
01120919	BLDG 18	7700 COOPER CREEK BLVD	RESMULTI
01120920	BLDG 19	7700 COOPER CREEK BLVD	RESMULTI
01120924	BLDG 20	7700 COOPER CREEK BLVD	RESMULTI
[illegible]		7700 COOPER CREEK BLVD	ASSEM
[illegible]		7700 COOPER CREEK BLVD	CONC3
[illegible]		7700 COOPER CREEK BLVD	CONC3
[illegible]		7700 COOPER CREEK BLVD	CONC3
[illegible]		7700 COOPER CREEK BLVD	CONC3
[illegible]		7700 COOPER CREEK BLVD	ACCESOR3
[illegible]		7700 COOPER CREEK BLVD	FENCE2
[illegible]		7700 COOPER CREEK BLVD	FENCE2
[illegible]		7700 COOPER CREEK BLVD	FENCE2

12/14/2001 07/14/21

REVIEWED FOR CODE COMPLIANCE WITH THE FLORIDA BUILDING CODE MANATEE COUNTY BUILDING DEPARTMENT

PERMIT NO: 01120814

REVIEW COMPLETED: 11-12-02

PLANS EXAMINER: CB

THESE DRAWINGS HAVE NOT BEEN REVIEWED FOR COMPLIANCE WITH THE (PLUMBING) (MECHANICAL) (GAS) (ELECTRICAL) CODE(S). ANY QUESTIONS REGARDING THE REQUIREMENTS OF THESE CODES SHOULD BE DIRECTED TO THE BUILDING INSPECTOR IN THE APPROPRIATE TRADE.

11-8-02

Jordan & Skala Engineers, Inc.
Job Number - 0110380
6630-P UNITY DRIVE, NORCROSS, GA 30071
PHONE (770)447-9647 FAX (770)448-0252
EMAIL: jse@jordanskala.com

COPYRIGHT © 2001 JORDAN & SKALA ENGINEERS INC.

COPYRIGHT 2001 The Barrington Group Incorporated

Project Architect
Ted Trout
Architect
Florida Registration #AR0016924
P.O. Box 820632
Houston, Texas 77282
Tel: (713) 818-3337
Fax: (281) 531-9535

Design Consultant
Mulvaney & Associates
[illegible]
Tel: (713) 527-[illegible]
Fax: (713) 524-[illegible]

CAROLINA LANDINGS

AT University Place

Manatee County, Florida
Job No. 0130

CLIENT REVIEW
Date: 11-27-01
INITIAL PERMIT REVIEW
Date: 12-05-01
PERMIT ISSUE
Date: 12-10-01
PERMIT/PRICING REVISION
Date: 01-28-02
OWNER REVISION #1
Date: 11-8-02
Date:
Date:
Date:

M2.1