permit_no	lot	address	permit_type
01120814	BLDG 1	7700 COOPER CREEK BLVD	RESMULTI
01120863	BLDG 2	7700 COOPER CREEK BLVD	RESMULTI
01120864	BLDG 3	7700 COOPER CREEK BLVD	RESMULTI
01120865	BLDG 4	7700 COOPER CREEK BLVD	RESMULTI
01120866	BLDG 5	7700 COOPER CREEK BLVD	RESMULTI
01120867	BLDG 6	7700 COOPER CREEK BLVD	RESMULTI
01120869	BLDG 7	7700 COOPER CREEK BLVD	RESMULTI
01120875	BLDG 8	7700 COOPER CREEK BLVD	RESMULTI
01120880	BLDG 9	7700 COOPER CREEK BLVD	RESMULTI
01120883	BLDG 10	7700 COOPER CREEK BLVD	RESMULTI
01120889	BLDG 11	7700 COOPER CREEK BLVD	RESMULTI
01120901	BLDG 12	7700 COOPER CREEK BLVD	RESMULTI
01120902	BLDG 13	7700 COOPER CREEK BLVD	RESMULTI
01120904	BLDG 14	7700 COOPER CREEK BLVD	RESMULTI
01120917	BLDG 15	7700 COOPER CREEK BLVD	RESMULTI
01120918	BLDG 16	7700 COOPER CREEK BLVD	RESMULTI
01120920	BLDG 17	7700 COOPER CREEK BLVD	RESMULTI
01120923	BLDG 18	7700 COOPER CREEK BLVD	RESMULTI
01120924	BLDG 19	7700 COOPER CREEK BLVD	RESMULTI
[illegible]	BLDG 20	7700 COOPER CREEK BLVD	RESMULTI
[illegible]		7700 COOPER CREEK BLVD	RESMULTI
[illegible]		7700 COOPER CREEK BLVD	RESMULTI
[illegible]		7700 COOPER CREEK BLVD	RESMULTI
[illegible]		7700 COOPER CREEK BLVD	RESMULTI
[illegible]		7700 COOPER CREEK BLVD	RESMULTI
[illegible]		7700 COOPER CREEK BLVD	RESMULTI
[illegible]		7700 COOPER CREEK BLVD	RESMULTI
[illegible]		7700 COOPER CREEK BLVD	RESMULTI
[illegible]		7700 COOPER CREEK BLVD	ASSEM
[illegible]		7700 COOPER CREEK BLVD	CONC3
[illegible]		7700 COOPER CREEK BLVD	CONC3
[illegible]		7700 COOPER CREEK BLVD	CONC3
[illegible]		7700 COOPER CREEK BLVD	CONC3
[illegible]		7700 COOPER CREEK BLVD	CONC3
[illegible]		7700 COOPER CREEK BLVD	ACCESCOM3
[illegible]		7700 COOPER CREEK BLVD	FENCE2
[illegible]		7700 COOPER CREEK BLVD	FENCE2
[illegible]		7700 COOPER CREEK BLVD	FENCE2
[illegible]		7700 COOPER CREEK BLVD	FENCE2

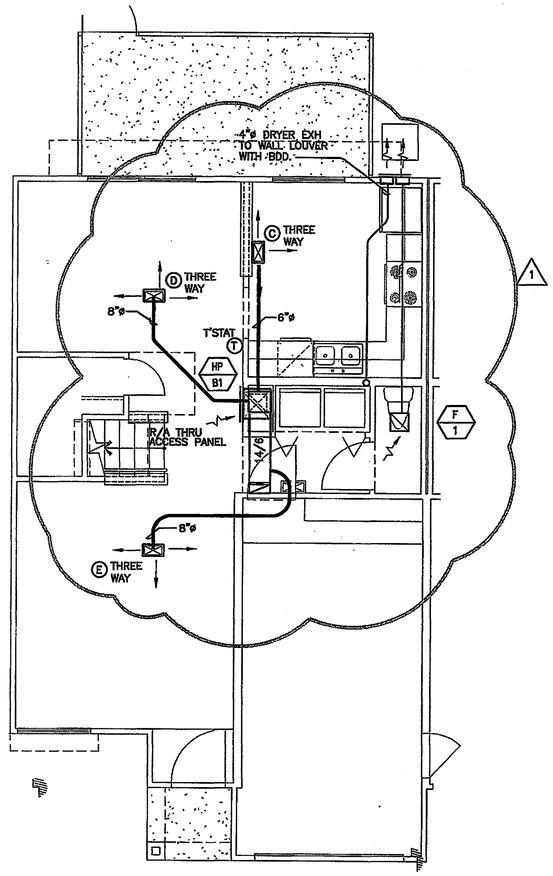

NOTE:
MECHANICAL CONTRACTOR SHALL KEEP EXHAUST VENT CAPS AND DRYER VENT CAP'S ALIGNED HORIZONTALLY.

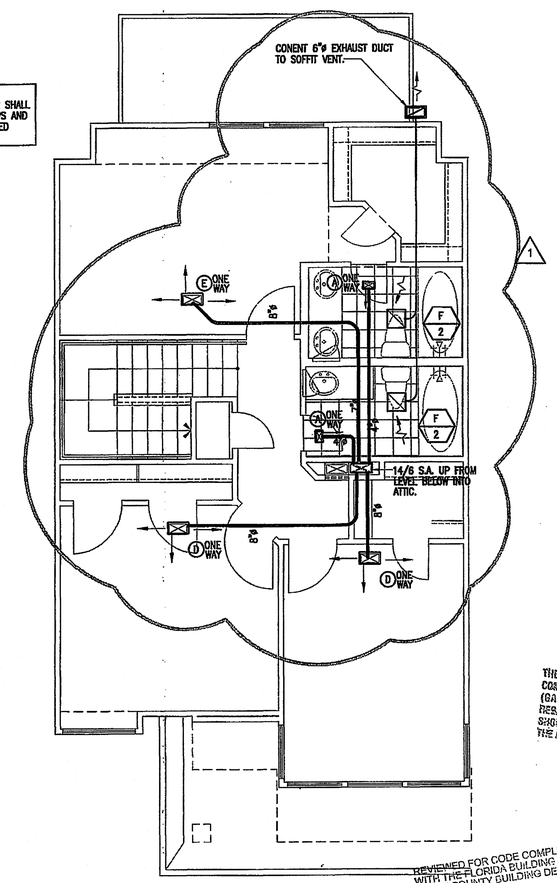

THESE DRAWINGS HAVE NOT BEEN REVIEWED FOR COMPLIANCE WITH THE (PLUMBING) (MECHANICAL) (GAS) (ELECTRICAL) CODE(S). ANY QUESTIONS REGARDING THE REQUIREMENTS OF THESE CODES SHOULD BE DIRECTED TO THE BUILDING INSPECTOR IN THE APPROPRIATE TRADE.

REVIEWED FOR CODE COMPLIANCE
WITH THE FLORIDA BUILDING CODE
MANATEE COUNTY BUILDING DEPARTMENT
PERMIT NO: 0112081-4
REVIEW COMPLETED: 11-12-02
PLANS EXAMINER: CB

11-8-02

1 M2.3 UNIT "B1" - Three Bedroom, 2 1/2 Bath

1/4" = 1'-0"

1,363 .. TOTAL

2 M2.3 UNIT "B1" - Three Bedroom, 2 1/2 Bath

1/4" = 1'-0"

1,363 .. TOTAL

Jordan & Skala Engineers, Inc.
Job Number - 0110380
6030-P UNITY DRIVE, NORCROSS, GA 30071
PHONE (770)447-5547 FAX (770)448-0262
EMAIL: jse@jordanskala.com

COPYRIGHT © 2001 JORDAN & SKALA ENGINEERS INC.

COPYRIGHT 2001 The Barrington Group Incorporated

Project Architect
Ted Trout Architect
Florida Registration #AR0016924
P.O. Box 820639
Houston, Texas 77282
Tel: (713) 818-3351
Fax: (281) 537-4335

Design Consultant
Vincenzo & Associates

CAROLINA LANDINGS
At University Place
Manatee County, Florida
Job No. 0110

CLIENT REVIEW	
Date: 11-27-01	
INITIAL PERMIT REVIEW	
Date: 12-05-01	
PERMIT ISSUE	
Date: 12-10-01	
PERMIT/ PRICING REVISION	
Date: 01-28-02	
1 OWNER REVISION #1	
Date: 11-8-02	
Date:	
Date:	
Date:	

M2.3